

HANCOCK

MISSISSIPPI BOARD OF WATER COMMISSIONERS

M 2121

10-22-65

WATER WELL DRILLERS LOG

Date: 10-22, 19 65, Driller: Sutter Well Works County Hancock

(Name)

(1) Owner of Land: Wm. Phillips

(Name)

2001 Almonster - New Orleans La

(Address)

(2) Location: SE 1/4, SE 1/4, Sec. 12 T5R15W

2 miles N of Lakeside

(distance)

(direction)

(Nearest Town)

(3) Topography: flat

(Hilly)

(Flat)

(Level)

(4) Purpose of Well: domestic home

(Domestic Irrigation, Municipal, Industrial, Other)

Description & Color of Materials
Sand, Clay, Red Clay, Shell, etc.

Thick-
ness
Feet

Depth
Feet

Clay-sand streaks

97 97

Sand

23 120

Clay

29 149


Sand

17 166

Information upon completion of well:

- (1) Diameter 2 inches.
(2) Total Depth 166 feet.
(3) Water Level 9 feet below top of ground.
(4) Cased to 161, Size 2"
(5) Screen: Size 2", Length 5'
(6) Were any formations sealed against pollution?
yes, no.

If YES depth of formation
Why
Drillers Remarks:

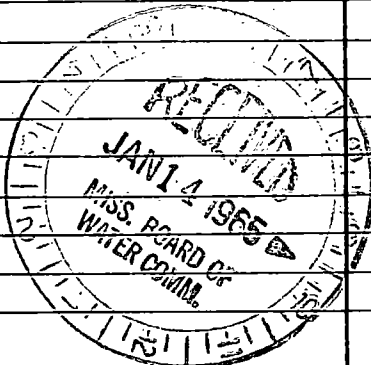

(Use Back Side)

Well No.

Handwritten notes at the top of the page, possibly including a date or title, which are mostly illegible due to fading and bleed-through.

A large table with a grid structure, likely a ledger or account book. It features multiple columns and rows, with some entries visible but mostly illegible. The table is oriented vertically on the left side of the page.

Handwritten notes and text on the right side of the page, including what appears to be a signature or name 'P. ...' and other illegible entries.