

COCK MISSISSIPPI BOARD OF WATER COMMISSIONERS

N 2002
7-20-62


WATER WELL DRILLERS LOG

(?)

Date: 7-20, 1962, Driller: C. T. SWITZER WELL CO. County: Hancock

(Name)

| (1) Owner of Land: | Description & Color of Materials Sand, Clay, Red Clay, Shell, etc. | Thick- ness Feet | Depth Feet |
|--|---|------------------------|---------------|
| <u>Ray Radner</u> (Name) | Clay | 00 | 12 |
| <u>Cement Harbor, Miss.</u> (Address) | Sand | 12 | 64 |
| (2) Location: <u>17 95 14</u> <u>18 T 5 R 9</u> | Clay | 64 | 97 |
| _____ miles _____ of _____ | Sand | 97 | 120 |
| (3) Topography: <input checked="" type="checkbox"/> (Hilly) <input type="checkbox"/> (Flat) <input type="checkbox"/> (Level) | Clay | 120 | 146 |
| (4) Purpose of Well: <u>Domestic Home</u> (Domestic Irrigation, Municipal, Industrial, Other) | Clay & Sand str | 146 | 166 |
| Information upon completion of well: | Sand | 166 | 181 |
| (1) Diameter <u>3</u> inches. | Clay | 181 | 246 |
| (2) Total Depth <u>835</u> feet. | Shell | 246 | 266 |
| (3) Water Level <u>24'</u> feet below top of ground. | Clay & Shell | 266 | 284 |
| (4) Cased to <u>835'</u> , Size <u>3"</u> | Sand | 284 | 352 |
| (5) Screen: Size <u>3"</u> , Length _____ | Clay | 352 | 382 |
| (6) Were any formations sealed against pollution? <input checked="" type="checkbox"/> yes, <input type="checkbox"/> no. | Sand str | 382 | 407 |
| If YES depth of formation _____ | Clay | 407 | 417 |
| Why <u>Health Dept. Requirement</u> | Sand | 417 | 457 |
| Drillers Remarks: _____ | Clay | 457 | 504 |
| _____ | Clay & shell | 504 | 524 |
| _____ | Clay & shell | 524 | 567 |
| _____ | Clay & shell | 567 | 598 |
| _____ | Sand | 598 | 609 |
| _____ | Clay | 609 | 681 |
| _____ | Sand | 681 | 710 |
| _____ | Clay & Sand str | 710 | 730 |
| _____ | Sand | 730 | 835 |

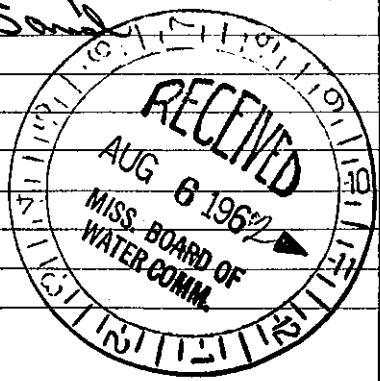

(Use Back Side)

Well No.

Mail this copy to Board of Water Commissioners 429 Miss. St. Jackson, Miss