

HANCOCK MISSISSIPPI BOARD OF WATER COMMISSIONERS

N 2003
9-12-62

WATER WELL DRILLERS LOG


M
Hancock

Date: Sept 12, 1962, Driller: Mar B Drilling Co. County Hancock
(Name)

(1) Owner of Land: Lee Quality Homes
(Name)
Cullpat, Miss.
(Address)
Rayside Park Subdivision
(2) Location: 1/4, 1/4, Sec. 5 T. 5 R. 17 E.
6 miles West of Bay St. Louis
(distance) (direction) (Nearest Town)
(3) Topography: Flat
(Hilly) (Flat) (Level)
(4) Purpose of Well: Domestic Home
(Domestic Irrigation
Municipal, Industrial, Other)

Description & Color of Materials Sand, Clay, Red Clay, Shell, etc.	Thick- ness Feet	Depth Feet
Clay	10	10
White Sand	20	30
White Clay	50	80
White Sand	20	100
White Clay	30	130
White Sand & Gravel	47	177
Blue Clay	177	177

Information upon completion of well:
63 FT - 2" - Balance 1 1/2
(1) Diameter 2 1/2 inches.
(2) Total Depth 173 feet.
(3) Water Level 6 feet below top of ground.
(4) Cased to 168, Size 2" X 1 1/2"
(5) Screen: Size 2" X 8 1/2", Length 5 FT.
(6) Were any formations sealed against pollution?
_____ yes, _____ no.
If YES depth of formation _____
Why _____
Drillers Remarks: _____

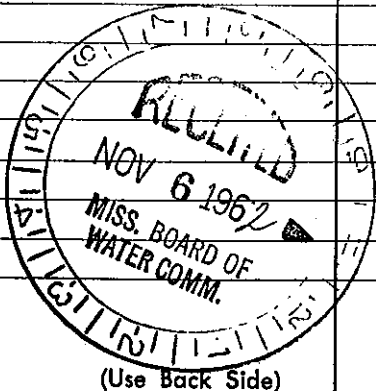

Well No.

Mail this copy to Board of Water Commissioners 429 Miss. St. Jackson, Miss