

HANCOCK MISSISSIPPI BOARD OF WATER COMMISSIONERS

N 2004

8-24-62

WATER WELL DRILLERS LOG

K

Date: 8-24, 1962, Driller: Dutter Well Works County Hancock

(Name)

(1) Owner of Land:	Description & Color of Materials Sand, Clay, Red Clay, Shell, etc.	Thick- ness Feet	Depth Feet
(Name) Ethel Segui	Clay	12	12
(Address) Waveland, Miss	sand	23	35
(2) Location: NW 1/4, NE 1/4, Sec. 4 T. 9 R. 14 W	Clay	123	158
	sand	18	176
(distance) miles 1 1/2 (direction) N (Nearest Town) Waveland			
(3) Topography: flat (Hilly) (Flat) (Level)			
(4) Purpose of Well: domestic home (Domestic Irrigation Municipal, Industrial, Other)			


Information upon completion of well:

- (1) Diameter 2 inches.
- (2) Total Depth 176 feet.
- (3) Water Level 8 feet below top of ground.
- (4) Cased to 171' all, Size 2"
- (5) Screen: Size 2', Length 5'
- (6) Were any formations sealed against pollution?  
yes,  no.

If YES depth of formation \_\_\_\_\_

Why \_\_\_\_\_

Drillers Remarks: \_\_\_\_\_

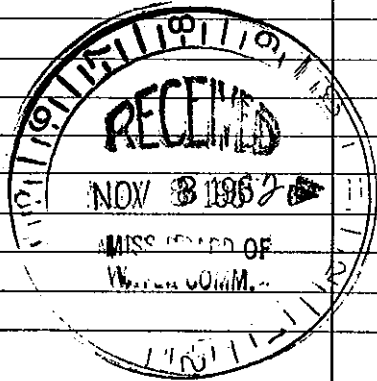

(Use Back Side)

Well No.

Mail this copy to Board of Water Commissioners 429 Miss. St. Jackson, Miss