

HANCOCK

MISSISSIPPI BOARD OF WATER COMMISSIONERS

N<sup>o</sup> 2006

11-6-62

WATER WELL DRILLERS LOG

K

Date: 11-6, 1962, Driller: Sutter Well Works County Hancock  
(Name)

(1) Owner of Land:	Description & Color of Materials Sand, Clay, Red Clay, Shell, etc.	Thick- ness Feet	Depth Feet
Geo. Koch (Name) Logtown Miss. (Address)	Clay	30	30
	Sand	16	46
(2) Location: NE 1/4, SW 1/4, Sec. 35 T85R14W	Clay	32	78
	Sand	29	107
2 miles SW, of Bay St Louis (distance) (direction) (Nearest Town)			
(3) Topography: flat (Hilly) (Flat) (Level)			
(4) Purpose of Well: Domestic Home (Domestic Irrigation Municipal, Industrial, Other)			


Information upon completion of well:

- (1) Diameter 2 inches.
- (2) Total Depth 107 feet.
- (3) Water Level 17 feet below top of ground.
- (4) Cased to 101, Size 2"
- (5) Screen: Size 2", Length 5'
- (6) Were any formations sealed against pollution?  
yes,  no.

If YES depth of formation

Why

Drillers Remarks:

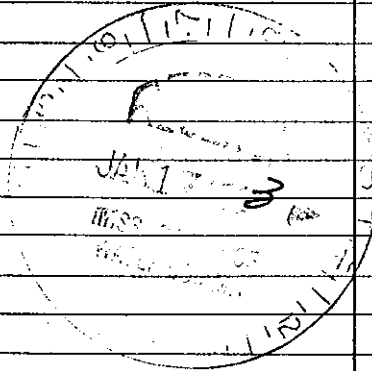

(Use Back Side)

Well No.

Mail this copy to Board of Water Commissioners 429 Miss. St. Jackson, Miss.