

HANCOCK MISSISSIPPI BOARD OF WATER COMMISSIONERS

N 2007
2-25-63

WATER WELL DRILLERS LOG

K

Date: 2-25, 1963, Driller: Sutter Well Works County Hancock

(Name)

(1) Owner of Land: <u>Catholic Church</u> (Name)	Description & Color of Materials Sand, Clay, Red Clay, Shell, etc.	Thick- ness Feet	Depth Feet
<u>Lakeshore Mississippi</u> (Address)	clay	20	20
(2) Location: <u>SW 1/4, SW 1/4, Sec. 18 T95R14W</u>	sand	13	33
_____ miles <u>IN</u> , of <u>Lakeshore</u> (distance) (direction) (Nearest Town)	clay	14	47
(3) Topography: _____ (Hilly) (Flat) (Level)	sand	18	65
(4) Purpose of Well: <u>Domestic - Church</u> (Domestic Irrigation Municipal, Industrial, Other)	clay	205	270
	sand	29	299


Information upon completion of well:

- (1) Diameter 2 inches.
- (2) Total Depth 299 feet.
- (3) Water Level 3 feet below top of ground.
- (4) Cased to all, Size 2"
- (5) Screen: Size 2", Length 5'
- (6) Were any formations sealed against pollution?
_____ yes, no.

If YES depth of formation _____

Why _____

Drillers Remarks: _____

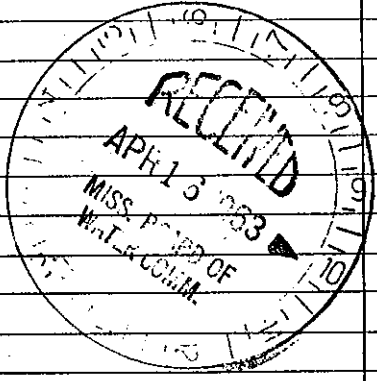

(Use Back Side)

Well No.

Mail this copy to Board of Water Commissioners 429 Miss. St. Jackson, Miss.