

HANCOCK MISSISSIPPI BOARD OF WATER COMMISSIONERS

N 2009
5-21-63

WATER WELL DRILLERS LOG

K

Date: 5-21, 1963, Driller: Sutter Well Works County Hancock
(Name)

(1) Owner of Land: <u>PM THOMPSON</u> (Name)	Description & Color of Materials Sand, Clay, Red Clay, Shell, etc.	Thick- ness Feet	Depth Feet
<u>Waveland Miss.</u> (Address)	sand	45	45
(2) Location: $\frac{1}{4}$, $\frac{1}{4}$, Sec. 3 T8R14W	clay	125	170
_____ miles <u>W</u> , of <u>Waveland</u> (distance) (direction) (Nearest Town)	sand	20	190
(3) Topography: <u>flat</u> (Hilly) (Flat) (Level)			
(4) Purpose of Well: <u>domestic home</u> (Domestic Irrigation Municipal, Industrial, Other)			


Information upon completion of well:

- (1) Diameter 2 inches.
- (2) Total Depth 190 feet.
- (3) Water level 10 feet below top of ground.
- (4) Cased to ape, Size 2"
- (5) Screen: Size 2", Length 5'
- (6) Were any formations sealed against pollution?
_____ yes, no.

If YES depth of formation _____

Why _____

Drillers Remarks: _____

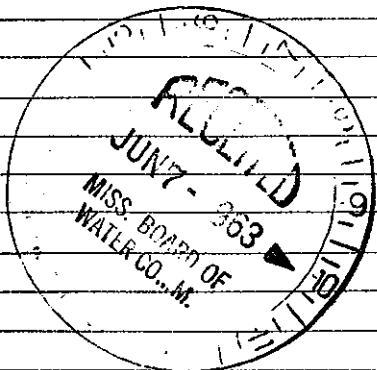

(Use Back Side)

Well No.

Mail this copy to Board of Water Commissioners 429 Miss. St. Jackson, Miss.