

MISSISSIPPI BOARD OF WATER COMMISSIONERS

HANCOCK

N 2010
9-8-63

WATER WELL DRILLERS LOG

Date: 4-9, 1963, Driller: C. T. SWITZER WELL CO. County: HANCOCK

(Name)

(1) Owner of Land:	Description & Color of Materials Sand, Clay, Red Clay, Shell, etc.	Thick- ness Feet	Depth Feet
(Name) <u>John Marie Deffer</u>	<u>Clay</u>	<u>00</u>	<u>10</u>
(Address) <u>Bay Side Park Bay St Louis</u> Town	<u>Sand</u>	<u>10</u>	<u>21</u>
(2) Location: <u>1/4</u> , <u>1/4</u> , Sec. <u>5</u> T. <u>95R</u> 14,	<u>Sand, good</u>	<u>21</u>	<u>60</u>
_____ miles _____ of _____ (distance) (direction) (Nearest Town)	<u>Clay</u>	<u>60</u>	<u>105</u>
(3) Topography: <input checked="" type="checkbox"/> (Hilly) <input type="checkbox"/> (Flat) <input type="checkbox"/> (Level)	<u>Sand, real good</u>	<u>105</u>	<u>150</u>
(4) Purpose of Well: <u>Domestic</u> (Home) (Domestic Irrigation Municipal, Industrial, Other)			

Information upon completion of well:

(1) Diameter 2 inches.

(2) Total Depth 150 feet.

(3) Water Level 6 1/2 feet below top of ground.

(4) Cased to 145', Size 2"


(5) Screen: Size 2", Length 8'

(6) Were any formations sealed against pollution?
 yes, no.

If YES depth of formation _____

Why Health Dept. requirement

Drillers Remarks: _____

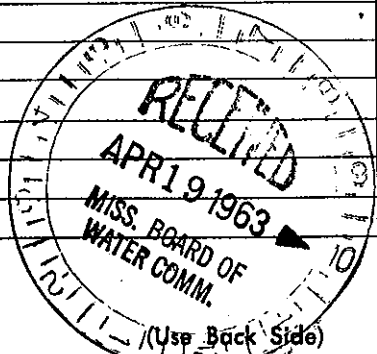

Well No.

Mail this copy to Board of Water Commissioners 429 Miss. St. Jackson, Miss