

HANCOCK MISSISSIPPI BOARD OF WATER COMMISSIONERS

N 2011

WATER WELL DRILLERS LOG

K

8-30-63

Date: *8-30*, 1963, Driller: *Sutter Well Works* County *Hancock*
(Name)

| | Description & Color of Materials Sand, Clay, Red Clay, Shell, etc. | Thick- ness Feet | Depth Feet |
|--|---|------------------------|---------------|
| (1) Owner of Land: <i>Milton Inch</i> (Name) <i>1120 Jena St. N.O. La.</i> (Address) | <i>Clay</i> | <i>10</i> | <i>10</i> |
| (2) Location: <i>SW 1/4, NW 1/4, Sec. 3 T9S R14, W</i> | <i>sand</i> | <i>50</i> | <i>60</i> |
| <i>1</i> miles <i>N</i> , of <i>Waveland</i> (distance) (direction) (Nearest Town) | <i>Clay</i> | <i>48</i> | <i>108</i> |
| (3) Topography: <i>flat</i> (Hilly) (Flat) (Level) | <i>sand</i> | <i>65</i> | <i>173</i> |
| (4) Purpose of Well: <i>domestic home</i> (Domestic Irrigation Municipal, Industrial, Other) | | | |


Information upon completion of well:

- (1) Diameter *2* inches.
- (2) Total Depth *173* feet.
- (3) Water Level *12* feet below top of ground.
- (4) Cased to *age*, Size *2"*
- (5) Screen: Size *2"*, Length *5'*
- (6) Were any formations sealed against pollution?
 yes, no.

If YES depth of formation _____

Why _____

Drillers Remarks: _____

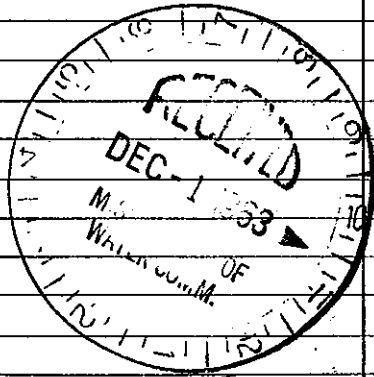

Well No.

(Use Back Side)

Mail this copy to Board of Water Commissioners 429 Miss. St. Jackson, Miss.