

HANCOCK MISSISSIPPI BOARD OF WATER COMMISSIONERS

N 2012
9-13-63

WATER WELL DRILLERS LOG

K

Date: 9-13, 1963, Driller: Sutton Well Works County Hancock
 (Name)

(1) Owner of Land: A. F. Lacoste
 (Name)
Waukegan, Miss
 (Address)

(2) Location: SW 1/4, NE 1/4, Sec. 4 T8R14W
1 miles N of Waukegan
 (distance) (direction) (Nearest Town)

(3) Topography: flat
 (Hilly) (Flat) (Level)

(4) Purpose of Well: domestic home
 (Domestic Irrigation
 Municipal, Industrial, Other)

Description & Color of Materials Sand, Clay, Red Clay, Shell, etc.	Thick- ness Feet	Depth Feet
<u>Clay</u>	<u>21</u>	<u>21</u>
<u>Sand, small clay strata</u>	<u>149</u>	<u>170</u>

Information upon completion of well:

(1) Diameter 2 inches.

(2) Total Depth 170 feet.

(3) Water Level 8 feet below top of
 ground.

(4) Cased to 165, Size 2"
400


(5) Screen: Size 2", Length 5'

(6) Were any formations sealed against pollution?
yes, no.

If YES depth of formation _____

Why _____

Drillers Remarks: _____

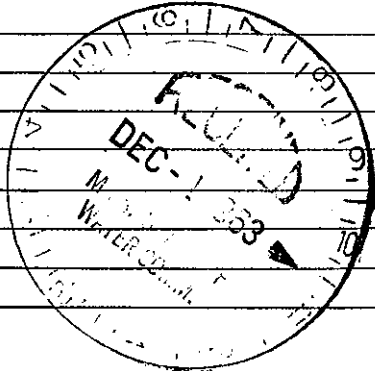

(Use Back Side)

Well No. _____

Mail this copy to Board of Water Commissioners 429 Miss. St. Jackson, Miss.