

HANCOCK MISSISSIPPI BOARD OF WATER COMMISSIONERS

N 2013  
9-R-63

WATER WELL DRILLERS LOG

K

Date: 9-18, 1963, Driller: Sutter Well Works County Hancock  
(Name)

(1) Owner of Land: <u>E. J. Alumnary</u> (Name)	Description & Color of Materials Sand, Clay, Red Clay, Shell, etc.	Thick- ness Feet	Depth Feet
<u>Waveland Miss.</u> (Address)	Clay	7	7
	sand	57	61
(2) Location: <u>SW 1/4, NW 1/4, Sec. 3 T9S R14 W</u>	Clay	41	102
	sand	71	173
<u>1</u> miles <u>N</u> , of <u>Waveland</u> (distance) (direction) (Nearest Town)			
(3) Topography: <u>flat</u> (Hilly) (Flat) (Level)			
(4) Purpose of Well: <u>domestic home</u> (Domestic Irrigation Municipal, Industrial, Other)			


Information upon completion of well:

- (1) Diameter 2 inches.
- (2) Total Depth 173 feet.
- (3) Water Level 10 feet below top of ground.
- (4) Cased to 168, Size 2"
- (5) Screen: Size 2", Length 5'
- (6) Were any formations sealed against pollution?  
\_\_\_\_\_ yes,  no.

If YES depth of formation \_\_\_\_\_

Why \_\_\_\_\_

Drillers Remarks: \_\_\_\_\_

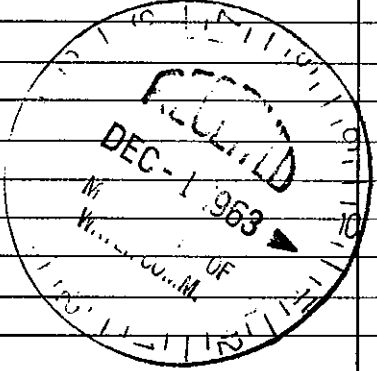

Well No.

(Use Back Side)

Mail this copy to Board of Water Commissioners 429 Miss. St. Jackson, Miss.