

HANCOCK MISSISSIPPI BOARD OF WATER COMMISSIONERS


N 2014
11-15-63

WATER WELL DRILLERS LOG

K

Date: 11-15, 1963, Driller: Sutton Well Works County Hancock
(Name)

(1) Owner of Land: <u>J. F. Carter</u> (Name)	Description & Color of Materials Sand, Clay, Red Clay, Shell, etc.	Thick- ness Feet	Depth Feet
<u>Pearlington Miss.</u> (Address)	<u>sand</u>	<u>45</u>	<u>45</u>
(2) Location: <u>SW 1/4, NE 1/4, Sec. 4 T. 9S R. 14W</u>	<u>clay</u>	<u>50</u>	<u>95</u>
<u>1</u> miles <u>N</u> , of <u>Waveland</u> (distance) (direction) (Nearest Town)	<u>sand</u>	<u>83</u>	<u>178</u>
(3) Topography: <u>flat</u> (Hilly) (Flat) (Level)			
(4) Purpose of Well: <u>domestic home</u> (Domestic Irrigation Municipal, Industrial, Other)			
Information upon completion of well:			
(1) Diameter <u>2</u> inches.			
(2) Total Depth <u>178</u> feet.			
(3) Water Level <u>7</u> feet below top of ground.			
(4) Cased to <u>173</u> , Size <u>2"</u>			
(5) Screen: Size <u>1 1/4"</u> , Length <u>5'</u>			
(6) Were any formations sealed against pollution?			
<u>no.</u>			
If YES depth of formation			
Why			
Drillers Remarks:			

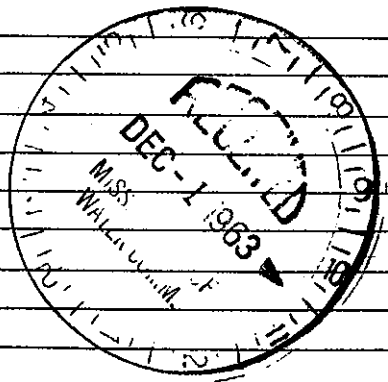

Well No.

(Use Back Side)

Mail this copy to Board of Water Commissioners 429 Miss. St. Jackson, Miss