

HANCOCK MISSISSIPPI BOARD OF WATER COMMISSIONERS

N 2016
12-26-63

WATER WELL DRILLERS LOG

K

Date: 12-26, 1963, Driller: Sutter Well Works County Hancock
(Name)

	Description & Color of Materials Sand, Clay, Red Clay, Shell, etc.	Thick- ness Feet	Depth Feet
(1) Owner of Land: <u>E. W. Ladner</u> (Name) <u>514 Madison St., N.O. La.</u> (Address)	Clay	40	40
(2) Location: <u>SE 1/4, NW 1/4, Sec. 19 T9S R14, W</u>	Sand	10	50
<u>4</u> miles <u>in</u> <u>Plaquemine</u> (distance) (direction) (Nearest Town)	Clay	140	190
(3) Topography: <u>flat</u> (Hilly) (Flat) (Level)	Sand	46	236
(4) Purpose of Well: <u>domestic home</u> (Domestic Irrigation Municipal, Industrial, Other)			


Information upon completion of well:

- (1) Diameter 2 inches.
- (2) Total Depth 236 feet.
- (3) Water Level — feet below top of ground.
- (4) Cased to all, Size 2"
- (5) Screen: Size 2", Length 5'
- (6) Were any formations sealed against pollution?
— yes, no.

If YES depth of formation _____

Why _____

Drillers Remarks: _____

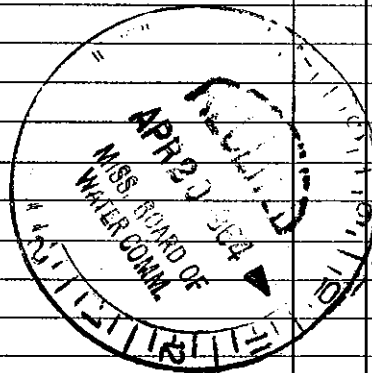

Well No.

(Use Back Side)

Mail this copy to Board of Water Commissioners 429 Miss. St. Jackson, Miss