

HANCOCK MISSISSIPPI BOARD OF WATER COMMISSIONERS

N 2018

2-29-64

WATER WELL DRILLERS LOG

K

Date: 2-29, 1964, Driller: Little Wood Works County Hancock
 (Name)

(1) Owner of Land:	Description & Color of Materials Sand, Clay, Red Clay, Shell, etc.	Thick- ness Feet	Depth Feet
<u>Joyce Cook</u> (Name)	<u>Clay</u>	<u>16</u>	<u>16</u>
<u>1108 Milan St - New Orleans, La</u> (Address)	<u>Sand + mud</u>	<u>52</u>	<u>68</u>
(2) Location: <u>N 1/4, SE 1/4, Sec. 4 T9S R14W</u>	<u>Clay - sand streaks</u>	<u>78</u>	<u>146</u>
<u>1</u> miles <u>N</u> of <u>Waveland</u> (distance) (direction) (Nearest Town)	<u>Sand + gravel</u>	<u>28</u>	<u>174</u>
(3) Topography: <u>flat</u> (Hilly) (Flat) (Level)			
(4) Purpose of Well: <u>Domestic Home</u> (Domestic Irrigation Municipal, Industrial, Other)			


Information upon completion of well:

- (1) Diameter 2 inches.
- (2) Total Depth 174 feet.
- (3) Water Level 8 feet below top of ground.
- (4) Cased to 169 feet, Size 2"
- (5) Screen: Size 2", Length 5'
- (6) Were any formations sealed against pollution?
 yes, no.

If YES depth of formation _____

Why _____

Drillers Remarks: _____

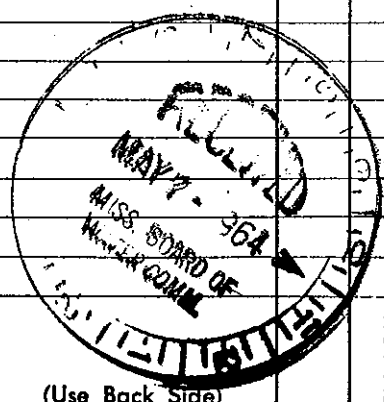

Well No. _____

(Use Back Side)

Mail this copy to Board of Water Commissioners 429 Miss. St. Jackson, Miss.