

~~HANCOCK~~ MISSISSIPPI BOARD OF WATER COMMISSIONERS

N 2020
9-28-64

WATER WELL DRILLERS LOG

*K

Date: 9-28, 1964, Driller: Butter Well Works County Hancock
(Name)

(1) Owner of Land: <u>E.H. Carpenter</u> (Name)	Description & Color of Materials Sand, Clay, Red Clay, Shell, etc.	Thick- ness Feet	Depth Feet
<u>Bay St. Louis, Miss.</u> (Address)	<u>Clay</u>	<u>10</u>	<u>10</u>
(2) Location: <u>NW 1/4, NW 1/4, Sec. 37 T85R14W</u>	<u>sand</u>	<u>28</u>	<u>38</u>
<u>2</u> miles <u>West</u> of <u>Bay St. Louis</u> (distance) (direction) (Nearest Town)	<u>Clay</u>	<u>72</u>	<u>110</u>
<u>flat</u> (Hilly) (Flat) (Level)	<u>sand</u>	<u>22</u>	<u>132</u>
(4) Purpose of Well: <u>domestic home</u> (Domestic Irrigation Municipal, Industrial, Other)	<u>Clay - sand streaks</u>	<u>103</u>	<u>235</u>
	<u>sand</u>	<u>41</u>	<u>276</u>


Information upon completion of well:

- (1) Diameter 2 inches.
- (2) Total Depth 276 feet.
- (3) Water Level 2 feet above Flow below top of ground.
- (4) Cased to all 276, Size 2"
- (5) Screen: Size 2", Length 5'
- (6) Were any formations sealed against pollution?
 yes, no.

If YES depth of formation Surface

Why _____

Drillers Remarks: _____

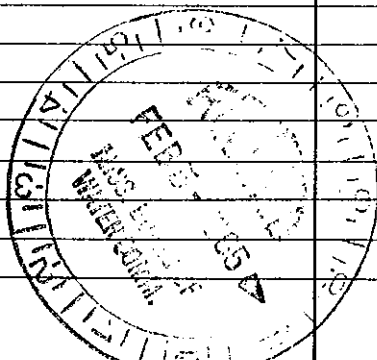

(Use Back Side)

Well No.