

HANCOCK

MISSISSIPPI BOARD OF WATER COMMISSIONERS

N 2091

2-22-65

WATER WELL DRILLERS LOG

A

Date: 2-22, 1965, Driller: Autter Well Works County Hancock

(Name)

(1) Owner of Land: Melvin Cagle
(Name)

7320 Chief Mouton - N.O. La.
(Address)

(2) Location: SW 1/4, NE 1/4, Sec. 6 T9S R14W

3 miles W of Bay St Louis
(distance) (direction) (Nearest Town)

(3) Topography: flat
(Hilly) (Flat) (Level)

(4) Purpose of Well: domestic HOME
(Domestic Irrigation
Municipal, Industrial, Other)

Description & Color of Materials
Sand, Clay, Red Clay, Shell, etc.

Thick-
ness
Feet

Depth
Feet

Clay 10 10

sand 45 55

Sandy clay 37 92

sand 27 119

Information upon completion of well:

(1) Diameter 2 inches.

(2) Total Depth 119 feet.

(3) Water Level 6 feet below top of ground. 114

(4) Cased to ape, Size 2"

(5) Screen: Size 2", Length 5'


(6) Were any formations sealed against pollution?

yes, no.

If YES depth of formation Surface

Why

Drillers Remarks:

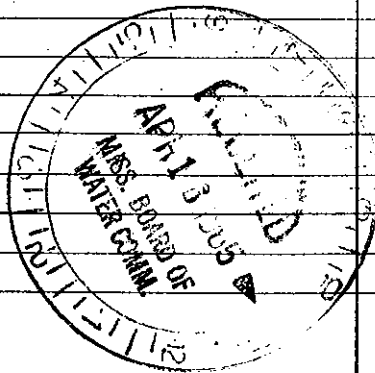

(Use Back Side)

Well No.

Mail this copy to Board of Water Commissioners 429 Miss. St. Jackson, Miss