

HANCOCK MISSISSIPPI BOARD OF WATER COMMISSIONERS

N 2022
3-9-65

WATER WELL DRILLERS LOG

A

Date: 3-9, 1965, Driller: Lutter Well Works County Hancock
(Name)

(1) Owner of Land: <u>O. J. Angle</u> (Name)	Description & Color of Materials Sand, Clay, Red Clay, Shell, etc.	Thick- ness Feet	Depth Feet
<u>510 Wagner St. - N.O. La.</u> (Address)	Clay	58	38
	Sand	28	66
(2) Location: <u>NE 1/4, SW 1/4, Sec. 20 T9S R14 W</u>	Clay	40	106
<u>1</u> miles <u>S</u> of <u>Lakeside</u> (distance) (direction) (Nearest Town)	Sand	23	129
	Clay	99	228
(3) Topography: <u>flat</u> (Hilly) (Flat) (Level)	fine Sand	22	250
	Sand	51	301
(4) Purpose of Well: <u>domestic Home</u> (Domestic Irrigation Municipal, Industrial, Other)	Clay	23	324
	fine Sand	11	335
	Sand	37	372


Information upon completion of well:

- (1) Diameter 2 inches.
- (2) Total Depth 372 feet. plow
- (3) Water Level 1 feet above below top of ground. 362
- (4) Cased to all, Size 2"
- (5) Screen: Size 2", Length 10'
- (6) Were any formations sealed against pollution?
 yes, no.

If YES depth of formation _____

Why _____

Drillers Remarks: _____

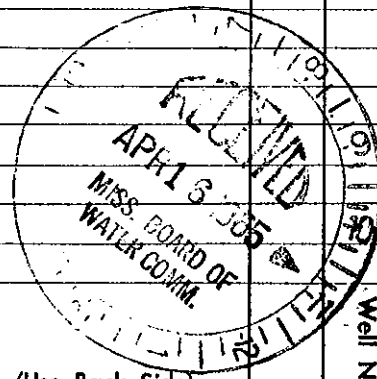

(Use Back Side)

Well No. _____

Mail this copy to Board of Water Commissioners 429 Miss. St. Jackson, Miss