

N 2073

WATER WELL DRILLERS LOG

5-8-65

Date: May 8, 1965, Drillers: Joe Miller County: Hancock

(Name)

	Description & Color of Materials Sand, Clay, Red Clay, Shell, etc.	Thick- ness Feet	Depth Feet
(1) Owner of Land: <u>Geo Claudel</u> <u>Waveland</u> (Name) <u>Bay St Louis Miss.</u> (Address)	<u>Hard Red + White Ch</u>	<u>8</u>	<u>8</u>
(2) Location: <u>1/4, 1/4, Sec. 3 T5R14W</u>	<u>White Sand etc</u>	<u>20</u>	<u>28</u>
_____ miles _____ of _____ (distance) (direction) (Nearest Town)	<u>Brn Sd, Wood, Shells</u>	<u>30</u>	<u>58</u>
(3) Topography: <u>Flat</u> (Hilly) (Flat) (Level)	<u>Hard Gray + Blue Cl</u>	<u>79</u>	<u>137</u>
(4) Purpose of Well: <u>Domestic Home</u> (Domestic Irrigation Municipal, Industrial, Other)	<u>Softer Clay</u>	<u>21</u>	<u>158</u>
	<u>Gray Sand, (Fair)</u>	<u>10</u>	<u>168</u>
	" " " "	<u>11</u>	<u>179</u>
	<u>Chay Sd, ? NQ.</u>	<u>7</u>	<u>186</u>
		<u>12</u>	<u>198</u>

Information upon completion of well:


- (1) Diameter 2" inches.
- (2) Total Depth 198' feet.
- (3) Water Level 10' feet below top of ground.
- (4) Cased to _____, Size 2"
- (5) Screen: Size _____, Length _____
- (6) Were any formations sealed against pollution?
_____ yes, _____ no.

If YES depth of formation _____

Why _____

Drillers Remarks: _____

13' Tail Pipe

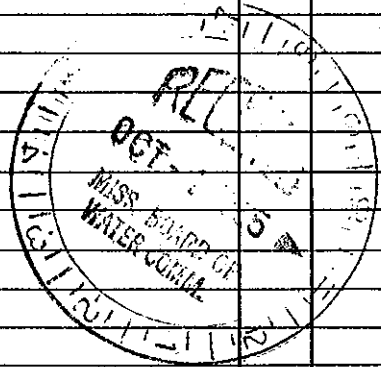

Well No.

(Use Back Side)