

HANCOCK

MISSISSIPPI BOARD OF WATER COMMISSIONERS

V 7895

5-21-65

WATER WELL DRILLERS LOG

Date: 5/21, 1965, Driller: Better Well Works County Hancock

(Name)

(1) Owner of Land: L.R. Calves (Name)

Waveland, Miss. (Address)

(2) Location: SW 1/4, SW 1/4, Sec. 3 T9S, R14, W10

1 miles N of Waveland (distance) (direction) (Nearest Town)

(3) Topography: flat (Hilly) (Flat) (Level)


(4) Purpose of Well: domestic home (Domestic Irrigation Municipal, Industrial, Other)

Description & Color of Materials Sand, Clay, Red Clay, Shell, etc.	Thick-ness Feet	Depth Feet
sand	40	40
clay	53	93
Clay-sand str.	114	207
sand	8	215
Clay-sand str.	37	252
sand	28	280

Information upon completion of well:

- (1) Diameter 2 inches.
- (2) Total Depth 280 feet.
- (3) Water Level 17 feet below top of ground.
- (4) Cased to 12' all, Size 2"
- (5) Screen: Size 2", Length 5'
- (6) Were any formations sealed against pollution?
yes, no.

If YES depth of formation
Why
Drillers Remarks:

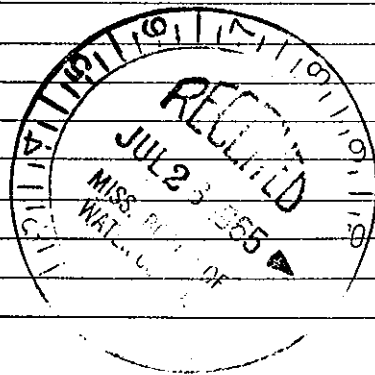

(Use Back Side)

Well No.

Mail this copy to Board of Water Commissioners 429 Miss. St. Jackson, Miss