

HANCOCK

MISSISSIPPI BOARD OF WATER COMMISSIONERS

N 2026

6-21-65

WATER WELL DRILLERS LOG

Date: 6-21, 1965, Driller: Sutter Well Works County Hancock

(Name)

(1) Owner of Land: Bert Courage (Name) Lakeshore (Address)

(2) Location: NW 1/4, SE 1/4, Sec. 7E T9S R14E 1 miles E of Lakeshore (distance) (direction) (Nearest Town)

(3) Topography: flat (Hilly) (Flat) (Level)

(4) Purpose of Well: domestic home (Domestic Irrigation Municipal, Industrial, Other)

Information upon completion of well:


- (1) Diameter 2 inches.
(2) Total Depth 286 feet.
(3) Water Level 3 feet below top of ground.
(4) Cased to 276 feet, Size 2"
(5) Screen: Size 2", Length 10'
(6) Were any formations sealed against pollution? yes, no.

If YES depth of formation

Why

Drillers Remarks:

Table with 4 columns: Description & Color of Materials, Thickness Feet, Depth Feet. Rows include Clay (150, 150), Sand (33, 184), Clay (65, 249), and silt (37, 286).

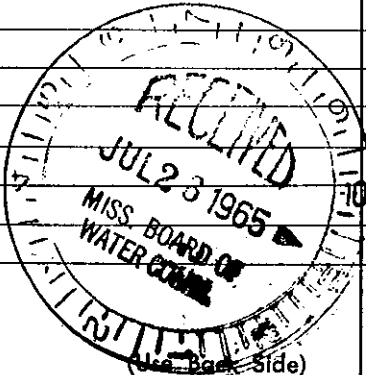

Well No.

Mail this copy to Board of Water Commissioners 429 Miss. St. Jackson, Miss.