

HANCOCK

MISSISSIPPI BOARD OF WATER COMMISSIONERS

N 2027  
6-24-65

WATER WELL DRILLERS LOG

Date: 6-24, 1965, Driller: Butter Well Works County Hancock  
(Name)

(1) Owner of Land: <u>J. F. Parker</u> (Name)	Description & Color of Materials Sand, Clay, Red Clay, Shell, etc.	Thick- ness Feet	Depth Feet
<u>Bay St. Louis, Miss</u> (Address)	Clay	98	98
(2) Location <u>NE 1/4, SW 1/4, Sec. 35 T8S R14 W</u>	Sand	42	140
<u>1</u> miles <u>N</u> of <u>Waveland</u> (distance) (direction) (Nearest Town)	Clay	42	182
(3) Topography: <u>flat</u> (Hilly) (Flat) (Level)	Sand	29	211
(4) Purpose of Well: <u>domestic home</u> (Domestic Irrigation Municipal, Industrial, Other)	Clay	131	342
	fine sand	61	403
	sand	28	431


Information upon completion of well:

- (1) Diameter 2 inches.
- (2) Total Depth 431 feet.
- (3) Water Level 9 feet below top of ground. 421
- (4) Cased to all, Size 2"
- (5) Screen: Size 2", Length 10'
- (6) Were any formations sealed against pollution?  
no

If YES depth of formation \_\_\_\_\_

Why \_\_\_\_\_

Drillers Remarks: \_\_\_\_\_

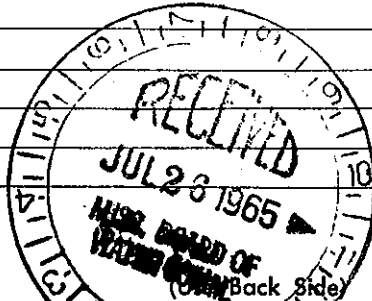

Well No.

Mail this copy to Board of Water Commissioners, 429 Miss. St. Jackson, Miss.