


HANCOCK  
N 2028  
7-27-65

WATER WELL DRILLERS LOG

Date: 7-27, 1965, Driller: Sutter Well Works County Hancock  
(Name)

(1) Owner of Land: <u>Cornelius Lachun</u> (Name)	Description & Color of Materials Sand, Clay, Red Clay, Shell, etc.	Thick- ness Feet	Depth Feet
<u>Bay St. Louis Miss.</u> (Address)	Clay	10	10
<u>85</u>	sand	49	58
(2) Location: <u>NE 1/4, SE 1/4, Sec. 34 T8S R14 E3</u> <u>1 miles N</u> , of <u>Waukegan</u> (distance) (direction) (Nearest Town)	Clay - fine sand streaks	34	402
(3) Topography: <u>flat</u> (Hilly) (Flat) (Level)	sand	84	476
(4) Purpose of Well: <u>domestic, home</u> (Domestic Irrigation Municipal, Industrial, Other)	Clay	41	517
Information upon completion of well:	sand	17	534
(1) Diameter <u>3</u> inches.	Clay	46	580
(2) Total Depth <u>1140</u> feet. <u>flow</u>	sand	43	623
(3) Water Level <u>27</u> feet <u>above</u> <u>below</u> top of ground.	Clay	15	638
(4) Cased to <u>1170</u> , Size <u>3"</u>	sand	132	770
(5) Screen: Size <u>3"</u> , Length <u>20'</u>	Clay	42	812
(6) Were any formations sealed against pollution? <input checked="" type="checkbox"/> yes, <input type="checkbox"/> no.	sand	21	833
If YES depth of formation _____	Clay	126	959
Why _____	sand	11	970
Drillers Remarks: _____	Clay	11	981
_____	sand	52	1033
_____	Clay	21	1054
_____	sand	86	1140
_____			
_____			
_____			

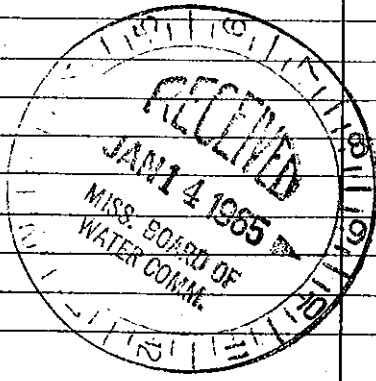

(Use Back Side)

Well No.

Mail this copy to Board of Water Commissioners 429 Miss. St. Jackson, Miss.