

HANCOCK

MISSISSIPPI BOARD OF WATER COMMISSIONERS

N 2032

9-8-65

WATER WELL DRILLERS LOG

Date: 9-8, 1965, Driller: Sutter Well Works County Hancock

(Name)

(1) Owner of Land: <u>H. S. Kimbrough</u> (Name)	Description & Color of Materials Sand, Clay, Red Clay, Shell, etc.	Thick- ness Feet	Depth Feet
<u>806 N. Beach, Bay St. Louis, Miss</u> (Address)	Clay	17	17
	Sand	41	58
(2) Location: <u>SW 1/4, NE 1/4, Sec. 3 T9S R14 W</u>	Clay - sand streaks	47	105
	sand	21	126
<u>1</u> miles <u>N</u> , of <u>Waveland</u> (distance) (direction) (Nearest Town)	Clay	22	148
	Red. gravel	22	170
(3) Topography: <u>flat</u> (Hilly) (Flat) (Level)			
(4) Purpose of Well: <u>domestic home</u> (Domestic Irrigation Municipal, Industrial, Other)			


Information upon completion of well:

- (1) Diameter 2 inches.
- (2) Total Depth 170 feet.
- (3) Water Level 9 feet below top of ground.
- (4) Cased to 165 feet, Size 2"
- (5) Screen: Size 2", Length 5'
- (6) Were any formations sealed against pollution?
 yes, no.

If YES depth of formation Surface

Why _____

Drillers Remarks: _____

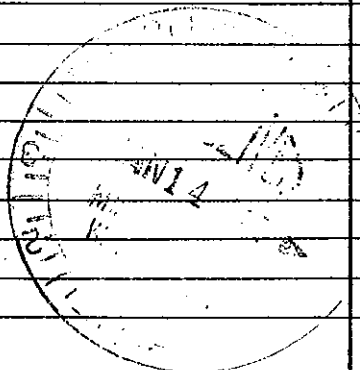

(Use Back Side)

Well No.

Mail this copy to Board of Water Commissioners 429 Miss. St. Jackson, Miss