

HANCOCK MISSISSIPPI BOARD OF WATER COMMISSIONERS

N 2033
9-22-65

WATER WELL DRILLERS LOG

Date: 9-22, 1965, Driller: Sutter Well Wks. County Hancock
(Name)

(1) Owner of Land: <u>J. P. Grome</u> (Name)	Description & Color of Materials Sand, Clay, Red Clay, Shell, etc.	Thick- ness Feet	Depth Feet
<u>Gen Delaney - Bay St Louis, Miss</u> (Address)	Clay	19	19
	sand	29	48
(2) Location: <u>NE 1/4, NW 1/4, Sec. 3 T9S R14 W</u>	Clay	40	88
<u>1</u> miles <u>N</u> of <u>Waveland</u> (distance) (direction) (Nearest Town)	sand	45	133
	Clay	21	154
(3) Topography: <u>flat</u> (Hilly) (Flat) (Level)	sand	19	173
(4) Purpose of Well: <u>domestic Home</u> (Domestic Irrigation Municipal, Industrial, Other)			


Information upon completion of well:

- (1) Diameter 2 inches.
- (2) Total Depth 173 feet.
- (3) Water Level 12 feet below top of ground.
- (4) Cased to 168, Size 2"
- (5) Screen: Size 3", Length 5'
- (6) Were any formations sealed against pollution?
yes, no.

If YES depth of formation _____

Why _____

Drillers Remarks: _____

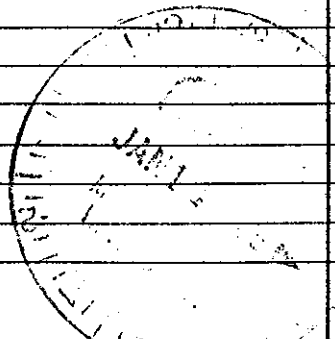

(Use Back Side)

Well No.

Mail this copy to Board of Water Commissioners 429 Miss. St. Jackson, Miss