

HANCOCK MISSISSIPPI BOARD OF WATER COMMISSIONERS

N 2034
9-23-65

WATER WELL DRILLERS LOG

Date: 9-23, 1965, Driller: Sutter Well Wks. County Hancock
(Name)

(1) Owner of Land: <u>Hancock Homes</u> (Name)	Description & Color of Materials Sand, Clay, Red Clay, Shell, etc.	Thick- ness Feet	Depth Feet
<u>108 Court St. Bay St. Louis, Miss</u> (Address)	<u>sand</u>	<u>48</u>	<u>48</u>
	<u>Clay</u>	<u>85</u>	<u>133</u>
(2) Location: <u>SW 1/4, NE 1/4, Sec. 4 T9SR14 W</u>	<u>sand</u>	<u>15</u>	<u>148</u>
<u>1</u> miles <u>N</u> , of <u>Waveland</u> (distance) (direction) (Nearest Town)	<u>Clay</u>	<u>7</u>	<u>155</u>
(3) Topography: <u>flat</u> (Hilly) (Flat) (Level)	<u>Sand</u>	<u>20</u>	<u>175</u>
(4) Purpose of Well: <u>domestic home</u> (Domestic Irrigation Municipal, Industrial, Other)			


Information upon completion of well:

- (1) Diameter 2 inches.
- (2) Total Depth 175 feet.
- (3) Water Level 8 feet below top of ground.
- (4) Cased to 170, Size 2"
- (5) Screen: Size 2", Length 5'
- (6) Were any formations sealed against pollution?
 yes, no.

If YES depth of formation surface

Why _____

Drillers Remarks: _____

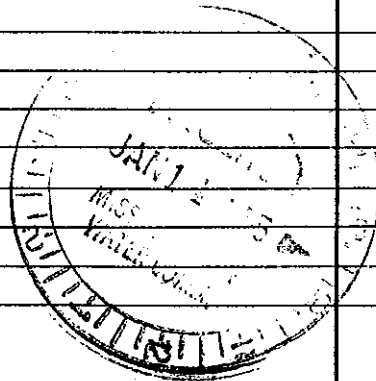

(Use Back Side)

Well No.

Mail this copy to Board of Water Commissioners 429 Miss. St. Jackson, Miss.