

HANCOCK

MISSISSIPPI BOARD OF WATER COMMISSIONERS

N 2035

10-5-65

WATER WELL DRILLERS LOG

Date: 10-5, 1965, Driller: Lutter Well Works County Hancock
(Name)

(1) Owner of Land:	Description & Color of Materials Sand, Clay, Red Clay, Shell, etc.	Thick- ness Feet	Depth Feet
Gerald Freeman (Name)	Clay	12	12
Waveland (Address)	Sand	36	48
(2) Location: SW 1/4, NE 1/4, Sec. 34 T85R14W	Clay	11	69
1 miles N of Waveland (distance) (direction) (Nearest Town)	Sand	56	125
(3) Topography: Flat (Hilly) (Flat) (Level)	Clay	65	190
(4) Purpose of Well: Domestic Home (Domestic Irrigation Municipal, Industrial, Other)	Clay - Sand streaks	51	241
	Sand	26	267


Information upon completion of well:

- (1) Diameter 2 inches.
- (2) Total Depth 267 feet.
- (3) Water Level 14 feet below top of ground.
- (4) Cased to 257 feet, Size 2"
- (5) Screen: Size 2", Length 10'
- (6) Were any formations sealed against pollution?
 yes, no.

If YES depth of formation _____

Why _____

Drillers Remarks: _____

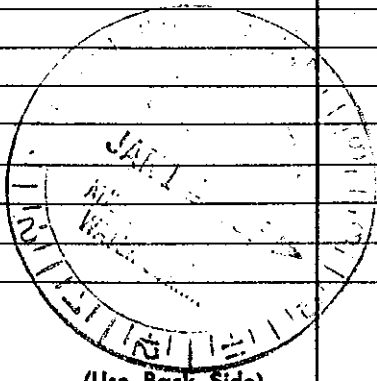

(Use Back Side)

Well No.

Mail this copy to Board of Water Commissioners 429 Miss. St. Jackson, Miss