

HANCOCK MISSISSIPPI BOARD OF WATER COMMISSIONERS

N 2037
10-29-65

WATER WELL DRILLERS LOG

Date: 10-29, 1965, Driller: Sutton Well Works County Hancock
(Name)

(1) Owner of Land: <u>John C Raoul</u> (Name)	Description & Color of Materials Sand, Clay, Red Clay, Shell, etc.	Thick- ness Feet	Depth Feet
<u>5215 Magazine St. New Orleans, La</u> (Address)	<u>Clay</u>	<u>10</u>	<u>10</u>
(2) Location: <u>SW 1/4, SW 1/4, Sec. 6 T9S R14, W</u>	<u>Sand</u>	<u>28</u>	<u>38</u>
<u>3</u> miles <u>W</u> of <u>Waveland</u> (distance) (direction) (Nearest Town)	<u>Clay</u>	<u>36</u>	<u>74</u>
(3) Topography: <u>flat</u> (Hilly) (Flat) (Level)	<u>Sand</u>	<u>38</u>	<u>112</u>
(4) Purpose of Well: <u>domestic home</u> (Domestic Irrigation Municipal, Industrial, Other)			


Information upon completion of well:

- (1) Diameter 2 inches.
- (2) Total Depth 112 feet.
- (3) Water Level 8 feet below top of ground.
- (4) Cased to 107, Size 2"
- (5) Screen: Size 1 1/2", Length 5'
- (6) Were any formations sealed against pollution?
 yes, no.

If YES depth of formation Surface

Why _____

Drillers Remarks: _____

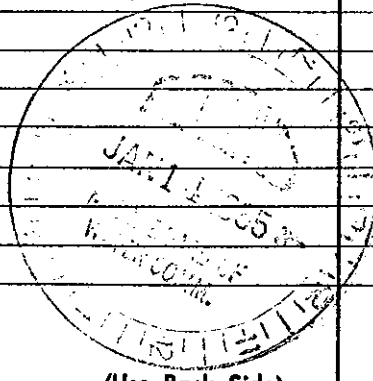

(Use Back Side)

Well No.

Mail this copy to Board of Water Commissioners 429 Miss. St. Jackson, Miss