

HANCOCK

MISSISSIPPI BOARD OF WATER COMMISSIONERS

N 2038

11-11-65

WATER WELL DRILLERS LOG

Date: 11-11, 1965, Driller: Sutter Well Works County Hancock
(Name)

(1) Owner of Land: <u>Chas. Dickson</u> (Name)	Description & Color of Materials Sand, Clay, Red Clay, Shell, etc.	Thick- ness Feet	Depth Feet
<u>Waveland</u> (Address)	Clay	8	8
(2) Location: <u>SW 1/4, NE 1/4, Sec. 34 T85R14W</u>	Sand	41	49
<u>1</u> miles <u>N</u> , of <u>Waveland</u> (distance) (direction) (Nearest Town)	Clay	47	96
(3) Topography: <u>flat</u> (Hilly) (Flat) (Level)	Sand	14	110
(4) Purpose of Well: <u>domestic home</u> (Domestic Irrigation Municipal, Industrial, Other)	Clay	80	190
	Sandy clay	14	204
	Clay	42	246
	Sand	16	262


Information upon completion of well:

- (1) Diameter 2 inches.
- (2) Total Depth 262 feet.
- (3) Water Level 12 feet below top of ground.
252
- (4) Cased to all, Size 2"
- (5) Screen: Size 2", Length 50'
- (6) Were any formations sealed against pollution?
_____ yes, no.

If YES depth of formation _____

Why _____

Drillers Remarks: _____

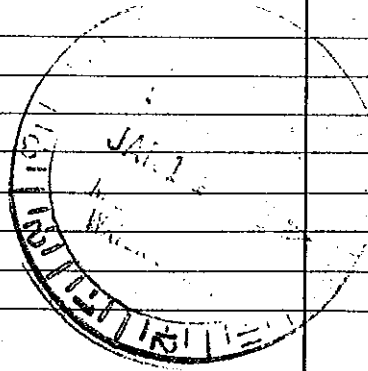

(Use Back Side)

Well No.

Mail this copy to Board of Water Commissioners 429 Miss. St. Jackson, Miss.