

HANCOCK

MISSISSIPPI BOARD OF WATER COMMISSIONERS

N 2039

11-11-65

WATER WELL DRILLERS LOG

Date: 11-11, 1965, Driller: Lutter West White County Hancock
(Name)

(1) Owner of Land:	Description & Color of Materials Sand, Clay, Red Clay, Shell, etc.	Thick- ness Feet	Depth Feet
(Name) <u>Chas. Wickson</u>			
	<u>Clay</u>	<u>11</u>	<u>11</u>
(Address) <u>Waveland</u>	<u>sand</u>	<u>43</u>	<u>54</u>
	<u>Clay</u>	<u>45</u>	<u>99</u>
(2) Location: <u>SW 1/4, NE 1/4, Sec. 34 T85R14, W2</u>	<u>sand</u>	<u>8</u>	<u>107</u>
	<u>Clay - sand streaks</u>	<u>137</u>	<u>244</u>
_____ miles <u>N</u> of <u>Waveland</u>	<u>sand</u>	<u>18</u>	<u>262</u>
(distance) _____ (direction) _____ (Nearest Town)			
(3) Topography: <u>flat</u>			
(Hilly) _____ (Flat) _____ (Level) _____			
(4) Purpose of Well: <u>Domestic Home</u>			
(Domestic Irrigation Municipal, Industrial, Other)			


Information upon completion of well:

- (1) Diameter 2 inches.
- (2) Total Depth 262 feet.
- (3) Water Level 12 feet below top of ground.
- (4) Cased to all, Size 2"
- (5) Screen: Size 2", Length 10'
- (6) Were any formations sealed against pollution?
_____ yes, no.

If YES depth of formation _____

Why _____

Drillers Remarks: _____

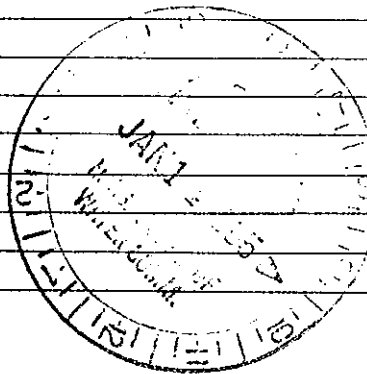

(Use Back Side)

Well No.

Mail this copy to Board of Water Commissioners 429 Miss. St. Jackson, Miss.