

N 2048
11-30-65

WATER WELL DRILLERS LOG

Date: 11-30, 1965, Driller: Sutter Well Wks. County Hancock
(Name)

	Description & Color of Materials Sand, Clay, Red Clay, Shell, etc.	Thick- ness Feet	Depth Feet
(1) Owner of Land: <u>J. J. Strong</u> (Name)	Clay	7	7
<u>Bay St. Louis, Miss</u> (Address)	Sand	47	54
(2) Location: <u>SE 1/4, SE 1/4, Sec. 34 T85R14W</u>	Clay	11	65
<u>1</u> miles <u>N</u> , of <u>Waveland</u> (distance) (direction) (Nearest Town)	Sand	19	84
(3) Topography: <u>flat</u> (Hilly) (Flat) (Level)	Clay	74	158
(4) Purpose of Well: <u>domestic home</u> (Domestic Irrigation Municipal, Industrial, Other)	Sand	17	175
	Clay	66	241
	Sand	24	265


Information upon completion of well:

- (1) Diameter 2 inches.
- (2) Total Depth 265 feet.
- (3) Water Level 12 feet below top of ground. 252
- (4) Cased to 400, Size 2"
- (5) Screen: Size 2", Length 10'
- (6) Were any formations sealed against pollution?
 yes, no.

If YES depth of formation surface

Why _____

Drillers Remarks: _____

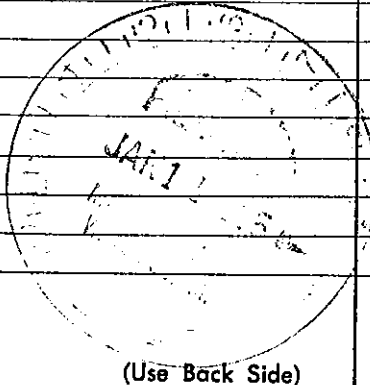

(Use Back Side)

Well No.