

HANCOCK MISSISSIPPI BOARD OF WATER COMMISSIONERS

N 2049

12-9-65

WATER WELL DRILLERS LOG


Date: 12-9, 1965, Driller: Antter Well Works County Hancock
(Name)

| (1) Owner of Land: <u>Hancock Homes</u> (Name) | Description & Color of Materials Sand, Clay, Red Clay, Shell, etc. | Thick- ness Feet | Depth Feet |
|--|---|------------------------|---------------|
| <u>Bay St. Louis Miss.</u> (Address) | Clay | 97 | 97 |
| (2) Location: <u>NE 1/4, SW 1/4, Sec. 35 T8SR14W</u> | sand | 39 | 136 |
| <u>1</u> miles <u>N</u> of <u>Waveland</u> (distance) (direction) (Nearest Town) | Clay | 47 | 183 |
| (3) Topography: <u>flat</u> (Hilly) (Flat) (Level) | sand | 31 | 214 |
| (4) Purpose of Well: <u>Domestic Home</u> (Domestic Irrigation Municipal, Industrial, Other) | Clay | 131 | 345 |
| | sand | 97 | 442 |
| | (top sand - fine) | | |

Information upon completion of well:

- (1) Diameter 2 inches.
- (2) Total Depth 442 feet.
- (3) Water Level 11 feet below top of ground.
439
- (4) Cased to all, Size 2"
- (5) Screen: Size 2", Length 10'
- (6) Were any formations sealed against pollution?
no.

If YES depth of formation _____
Why _____
Drillers Remarks: _____

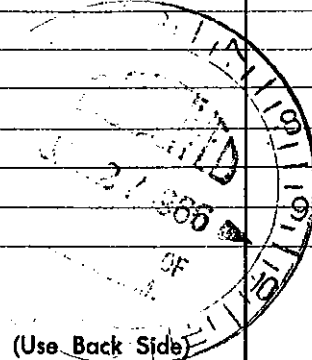

Well No. _____