

HANCOCK MISSISSIPPI BOARD OF WATER COMMISSIONERS

N 2043

M

12-4-62

WATER WELL DRILLERS LOG

Date: Dec. 4, 1962, Driller: H & B Drilling Co. County Hancock
(Name)

(1) Owner of Land: <u>Hancock Homes</u> <small>(Name)</small>	Description & Color of Materials Sand, Clay, Red Clay, Shell, etc.	Thick- ness Feet	Depth Feet
<u>P.O. Box Pass Christian, Miss.</u> <small>(Address)</small>	<u>Clay</u>	<u>18</u>	<u>18</u>
<u>Bay Side Park Subdivision</u> <small>(Address)</small>	<u>Black sand</u>	<u>30</u>	<u>48</u>
(2) Location: <u>1/4, 1/4, Sec. 5 T. 2 R. 14</u> <u>7 miles south Highway 70.</u>	<u>Black clay</u>	<u>10</u>	<u>58</u>
<u>6 miles West</u> , of <u>Bay St. Louis</u> <small>(distance) (direction) (Nearest Town)</small>	<u>Blue clay + Glass Shells</u>	<u>32</u>	<u>90</u>
(3) Topography: <u>Flat</u> <small>(Hilly) (Flat) (Level)</small>	<u>White coarse sand</u>	<u>33</u>	<u>123</u>
(4) Purpose of Well: <u>Domestic Home</u> <small>(Domestic Irrigation Municipal, Industrial, Other)</small>	<u>Blue clay</u>	<u>22</u>	<u>145</u>
	<u>Blue clay + Sand + Brackish</u>	<u>15</u>	<u>160</u>
	<u>Coarse white sand</u>		
	<u>Heavy black gravel, etc.</u>	<u>18</u>	<u>178</u>
			<u>on</u>


Information upon completion of well:

- (1) Diameter 2" X 1 1/4" inches.
- (2) Total Depth 173 feet.
- (3) Water Level 6 feet below top of ground. Balance 1 1/4"
- (4) Cased to 167 FT, Size 2" X 2"
- (5) Screen: Size 2 1/4" X 3/16", Length 5 FT.
- (6) Were any formations sealed against pollution?
 yes, no.

If YES depth of formation _____

Why _____

Drillers Remarks: _____

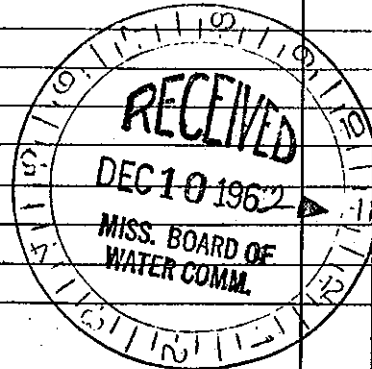

(Use Back Side)

Well No.

Mail this copy to Board of Water Commissioners 429 Miss. St. Jackson, Miss.