

HANCOCK

MISSISSIPPI BOARD OF WATER COMMISSIONERS

N 7044
12-23-65

WATER WELL DRILLERS LOG

Date: 12-23, 1965, Driller: Little Well Works County Hancock
(Name)

(1) Owner of Land: Chas. Wickson
(Name)
Waveland Driss
(Address)

(2) Location: SE 1/4, SE 1/4, Sec. 34 T85R14W
1 miles N of Waveland
(distance) (direction) (Nearest Town)

(3) Topography: flat
(Hilly) (Flat) (Level)

(4) Purpose of Well: Domestic Home
(Domestic Irrigation
Municipal, Industrial, Other)

Description & Color of Materials Sand, Clay, Red Clay, Shell, etc.	Thick- ness Feet	Depth Feet
Clay	10	10
Sand	48	58
Clay	27	85
Sand	17	102
Clay	133	235
Sand	34	269


Information upon completion of well:

- (1) Diameter 2 inches.
- (2) Total Depth 269 feet.
- (3) Water Level 14 feet below top of ground.
- (4) Cased to all, Size 2"
- (5) Screen: Size 2", Length 10'
- (6) Were any formations sealed against pollution?
 yes, no.

If YES depth of formation _____

Why _____

Drillers Remarks: _____

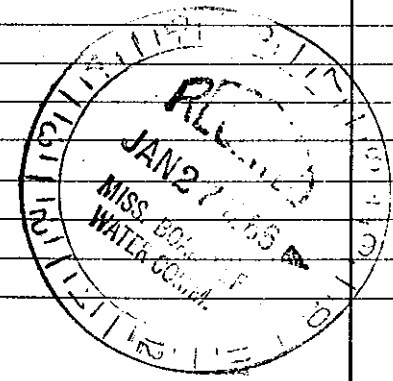

(Use Back Side)

Well No.

Mail this copy to Board of Water Commissioners 429 Miss. St. Jackson, Miss