

HANCOCK

MISSISSIPPI BOARD OF WATER COMMISSIONERS

N 7045

12-26-65 WATER WELL DRILLERS LOG

Date: 12-26, 1965, Driller: Better Well Works County Hancock

(Name)

(1) Owner of Land: First Assembly of God Church, Waveland, Miss.

Table with 3 columns: Description & Color of Materials, Thickness Feet, Depth Feet. Rows include Clay, Sand, Clay, Sand, Clay, Sand.


(2) Location: SE 1/4, SE 1/4, Sec. 34 T85R 14W, 1 miles N of Waveland

(3) Topography: flat

(4) Purpose of Well: Church & domestic

Information upon completion of well:

- (1) Diameter 2 inches. (2) Total Depth 270 feet. (3) Water Level 12 feet below top of ground. (4) Cased to 260, Size 2". (5) Screen: Size 2", Length 10'. (6) Were any formations sealed against pollution? yes, no.

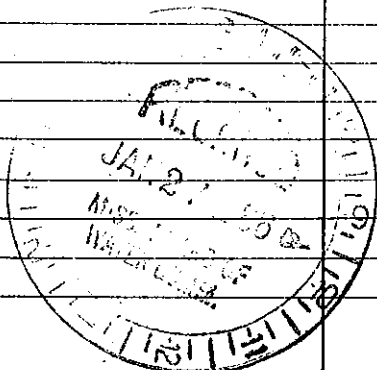

(Use Back Side)

Well No.

Mail this copy to Board of Water Commissioners 429 Miss. St. Jackson, Miss