

HANCOCK

MISSISSIPPI BOARD OF WATER COMMISSIONERS

N 7046

12-28-65

WATER WELL DRILLERS LOG

Date: 12-28, 19 65, Driller: Sutter Well Works County Hancock

(Name)

(1) Owner of Land: A. J. Butz (Name)
Waveland, Miss. (Address)

(2) Location: NE 1/4, NE 1/4, Sec. 3 T. 95R. 14. W
1 miles N, of Waveland (distance, direction, Nearest Town)

(3) Topography: flat (Hilly, Flat, Level)


(4) Purpose of Well: Domestic Home (Domestic Irrigation, Municipal, Industrial, Other)

Table with 3 columns: Description & Color of Materials, Thickness Feet, Depth Feet. Rows include Clay, sand, Clay, sand with corresponding measurements.

Information upon completion of well:

- (1) Diameter 2 inches.
(2) Total Depth 174 feet.
(3) Water Level 9 feet below top of ground.
(4) Cased to 169, Size 2"
(5) Screen: Size 2", Length 5'
(6) Were any formations sealed against pollution? yes, no.

If YES depth of formation
Why
Drillers Remarks:

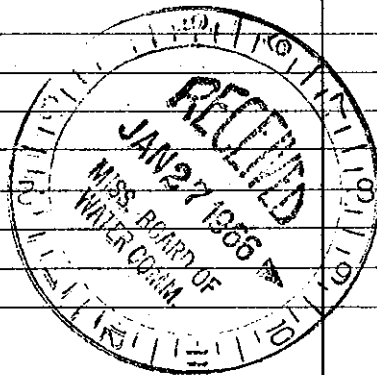

(Use Back Side)

Well No.