

HANCOCK MISSISSIPPI BOARD OF WATER COMMISSIONERS

N 2047

1-14-66

WATER WELL DRILLERS LOG

Date: 1-14, 1966, Driller: Sutter Well Works County Hancock
(Name)

(1) Owner of Land:	Description & Color of Materials Sand, Clay, Red Clay, Shell, etc.	Thick- ness Feet	Depth Feet
<u>Wifora Ashman</u> (Name)	Clay	26	26
<u>Bay St. Louis, Miss.</u> (Address)	Sand	19	45
(2) Location: <u>SW 1/4, NE 1/4, Sec. 4 T9SR14N</u>	Clay - sand streaks	108	153
<u>1</u> miles <u>N</u> , of <u>Waveland</u> (distance) (direction) (Nearest Town)	Sand	45	198
(3) Topography: <u>flat</u> (Hilly) (Flat) (Level)	Clay	30	228
(4) Purpose of Well: <u>domestic home</u> (Domestic Irrigation Municipal, Industrial, Other)	Sand	13	241
	Clay - sand streaks	196	437
	Sand	86	523
	Clay	74	597
	Sand	26	623
	Clay	1	624


Information upon completion of well:

- (1) Diameter 3 inches.
- (2) Total Depth 624 feet.
- (3) Water Level 3 feet ^{above} below top of ground.
- (4) Cased to 614 ^{all}, Size 3"
- (5) Screen: Size 3", Length 10'
- (6) Were any formations sealed against pollution?
 yes, no.

If YES depth of formation _____

Why _____

Drillers Remarks: _____

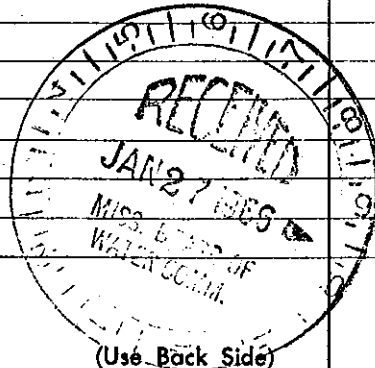

Well No. _____

Mail this copy to Board of Water Commissioners 429 Miss. St. Jackson, Miss