

HANCOCK

N 2048

MISSISSIPPI BOARD OF WATER COMMISSIONERS

4-12-66

WATER WELL DRILLERS LOG

Date: 4-12, 1966, Driller: Little Well Works County Hancock
(When well drilled) (Name) (Where well is located)

(1) Owner of Land: St. Ann's Church
(Name)
Clement Harbor, Miss.
(Address)

(2) Location: SW 1/4, NE 1/4, Sec. 8 T25R14, W2
1 miles N, of Clement Harbor
(distance) (direction) (Nearest Town)

(3) Topography: flat
(Hilly) (Flat) (Level)

(4) Purpose of Well: Church & domestic
(Domestic Irrigation
Municipal, Industrial, Other)

Description & Color of Materials Sand, Clay, Red Clay, Shell, etc.	Thick- ness Feet	Depth Feet
Clay	20	20
Sand	34	54
Clay - Sand streaks	210	264
Sand	47	311

Information upon completion of well:

- (1) Diameter 2 inches.
- (2) Total Depth 311 feet.
- (3) Water Level 9 feet below top of ground. 301
- (4) Cased to 6'6", Size 2"
- (5) Screen: Size 2", Length 10'
- (6) Were any formations sealed against pollution?
yes, no.

If YES depth of formation _____


Why _____

Drillers Remarks: _____

Yield in gpm: 25

Size pump: not furnished

Type power: _____

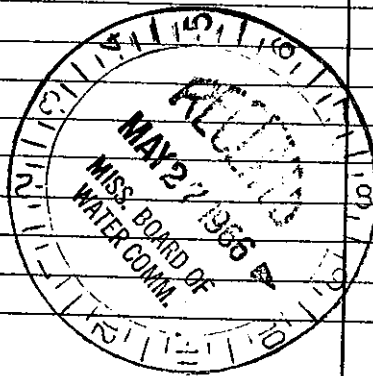

Mail this copy to Board of Water Commissioners 429 Miss. St. Jackson, Miss.