

HANCOCK

N 2080

MISSISSIPPI BOARD OF WATER COMMISSIONERS

5-2-66

WATER WELL DRILLERS LOG

Date: 5-2, 1966, Driller: Lutter Well Works County Hancock

(When well drilled)

(Name)

(Where well is located)

(1) Owner of Land: H. (Bully) Zengering

(Name)

Description & Color of Materials
Sand, Clay, Red Clay, Shell, etc.

Thick-
ness
Feet

Depth
Feet

Bay St. Louis Miss.

(Address)

TOWN

Clay

6

6

Sand

53

59

Clay

62

121

Sand

12

133

(2) Location: 1/4, 1/4, Sec. 37 T. 5 R. 14

miles

IN

Bay St. Louis

(distance)

(direction)

(Nearest Town)

(3) Topography: flat

(Hilly)

(Flat)

(Level)

(4) Purpose of Well: Domestic Home

(Domestic Irrigation
Municipal, Industrial, Other)

Information upon completion of well:

(1) Diameter 2 inches.

(2) Total Depth 131 feet.

(3) Water Level 18 feet below top of ground.

126

(4) Cased to all, Size 2"

(5) Screen: Size 2", Length 5'

(6) Were any formations sealed against pollution?

yes, no.

If YES depth of formation


Why

Drillers Remarks:

Yield in gpm: 15

Size pump: 1 hp

Type power: elec.

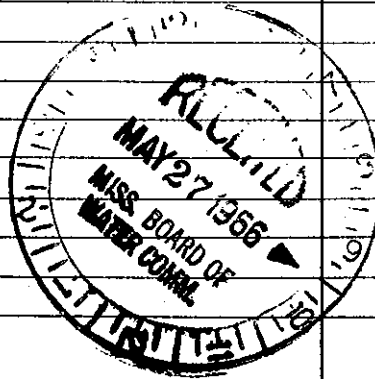

Mail this copy to Board of Water Commissioners 429 Miss. St. Jackson, Miss.