

Hancock
N 2082

7-18-66

MISSISSIPPI BOARD OF WATER COMMISSIONERS

WATER WELL DRILLERS LOG

Date: 7-18, 1966, Driller: Sutter Well Works County Hancock
(When well drilled) (Name) (Where well is located)

(1) Owner of Land: Beatie Evans
(Name)
Rt 2 Bay St Louis
(Address)

(2) Location: SW 1/4, SW 1/4, Sec. 7 T9S R14W
2 miles W, of Waveland
(distance) (direction) (Nearest Town)

(3) Topography: flat
(Hilly) (Flat) (Level)

(4) Purpose of Well: domestic home
(Domestic Irrigation, Municipal, Industrial, Other)

Description & Color of Materials Sand, Clay, Red Clay, Shell, etc.	Thick- ness Feet	Depth Feet
Clay	8	8
sand	27	35
Clay	52	87
Red	28	115
Clay	29	144
gray sand	14	158

Information upon completion of well:

- (1) Diameter 2 inches.
- (2) Total Depth 158 feet.
- (3) Water Level 8 feet below top of ground.
- (4) Cased to 153, Size 2"
- (5) Screen: Size 2", Length 5'
- (6) Were any formations sealed against pollution?
 yes, no.

If YES depth of formation Surface


Why _____

Drillers Remarks: _____

Yield in gpm: 15

Size pump: 1/2

Type power: elec.

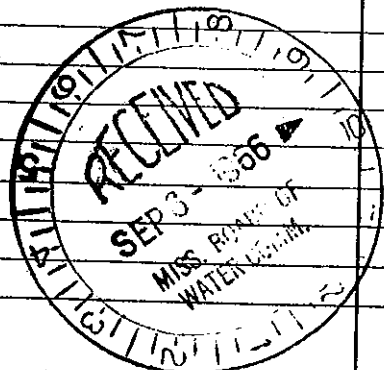

Mail this copy to Board of Water Commissioners 429 Miss. St. Jackson, Miss.