

Hancock

N 2056

9-66

MISSISSIPPI BOARD OF WATER COMMISSIONERS

WATER WELL DRILLERS LOG

Date: 4-19, 1966, Driller: Sutter Well Works County Hancock

(When well drilled)

(Name)

(Where well is located)

(1) Owner of Land: Abe Williams (Name) Lakeshore Miss (Address)

(2) Location: SW 1/4, SW 1/4, Sec. 18 T9S R14, 1 miles N of Lakeshore (distance) (direction) (Nearest Town)


(3) Topography: flat (Hilly) (Flat) (Level)

(4) Purpose of Well: domestic home (Domestic Irrigation Municipal, Industrial, Other)

Table with 3 columns: Description & Color of Materials (Sand, Clay, Red Clay, Shell, etc.), Thickness Feet, Depth Feet. Rows include Clay 17, Sand 19, Clay 44, Sand 47, Clay 43, Sand 45.

Information upon completion of well:

- (1) Diameter 2 inches. (2) Total Depth 215 feet. (3) Water Level 6 feet below top of ground. (4) Cased to All, Size 2". (5) Screen: Size 2", Length 5'. (6) Were any formations sealed against pollution? yes, no.

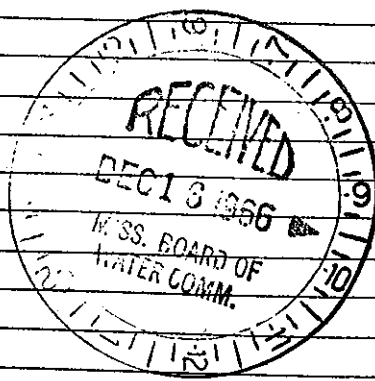

If YES depth of formation Why Drillers Remarks: Yield in gpm: 12 Size pump: 1/2 hp Type power: elec

Mail this copy to Board of Water Commissioners 429 Miss. St. Jackson, Miss.