

Hancock
N 2059
9-66

MISSISSIPPI BOARD OF WATER COMMISSIONERS

WATER WELL DRILLERS LOG

Date: 9-26, 1966, Driller: Sutter Well Works County Hancock
(When well drilled) (Name) (Where well is located)

(1) Owner of Land: E. E. Col
(Name)
Bayside Park - Bay St Louis
(Address)
(2) Location: SW 1/4, SW 1/4, Sec. 6 T95R14W
3 miles NW of Waveland
(distance) (direction) (Nearest Town)
(3) Topography: flat
(Hilly) (Flat) (Level)
(4) Purpose of Well: domestic home
(Domestic Irrigation
Municipal, Industrial, Other)

Description & Color of Materials Sand, Clay, Red Clay, Shell, etc.	Thick- ness Feet	Depth Feet
clay	16	16
sand	22	38
clay	52	90
sand	36	126
clay	49	175
sand	40	215

Information upon completion of well:

(1) Diameter 2 inches.
(2) Total Depth 215 feet.
(3) Water Level 7 feet below top of ground. 210
(4) Cased to all, Size 2"
(5) Screen: Size 2", Length 5'
(6) Were any formations sealed against pollution?
yes, no.

If YES depth of formation _____


Why _____

Drillers Remarks: _____

Yield in gpm: 10

Size pump: 1/2 hp

Type power: elec

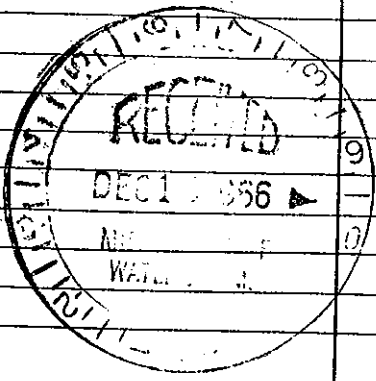

Mail this copy to Board of Water Commissioners 429 Miss. St. Jackson, Miss.