

N2060

Hancock

N 2060

4-67

MISSISSIPPI
BOARD OF WATER COMMISSIONERS
416 North State Street
Jackson, Mississippi 39201

WATER WELL DRILLERS LOG

4-10 19 67 Sutton Well Works Hancock
date well completed firm name county well located

LANDOWNER: Mrs. HAZEL STEPHENS

Box 336

Waveland Miss -
(mailing address)

description of formations encountered	from	to
Clay	0	10
Sand	10	46
Clay	46	147
Sand	147	165


WELL LOCATION:

sec. 7 T. 9 N. R. 14 W.
S. W.
1 miles N of Clement Harbor
(distance) (direction) (nearest town)

WELL PURPOSE: Home
(home, irrigation, municipal, industrial)

WELL COMPLETION DATA:

- (1) diameter (inches) 2
- (2) total depth (feet) 165
- (3) static water level (feet) 7 below above top of ground.
- (4) casing galv. 160'
(material) (depth)
if telescope see back.
(size)
- (5) screen 5' 160'
(length) (depth to top)
2" stainless steel
(size) (material)
- (6) pump 1/2 10
(HP) (yield gpm)
elec
(type power)
- (7) electric log No
(yes or no)
(organization running log)
- (8) how well bottom plugged B.P. Value

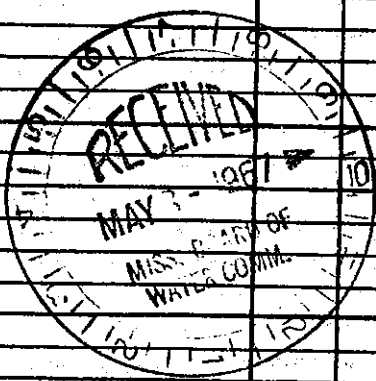

DRILLERS REMARKS: