

N2064

Hancock

N2064

9-67

MISSISSIPPI

BOARD OF WATER COMMISSIONERS

416 North State Street

Jackson, Mississippi 39201

WATER WELL DRILLERS LOG

9-29 1967 Sutter Well Works Hancock
date well completed firm name county well located

LANDOWNER: Chas. Jackson
Box 197

description of formations encountered

from to

Clermont Wash, Miss.
(mailing address)

Clay
sand

0 8
8 46

WELL LOCATION:

sec. 8 T. 9 S. R. 14 E. W.
1 miles N of Clermont Wash
(distance) (direction) (nearest town)


Clay
sand
Clay
sand

46 172
172 202
202 265
265 304

WELL PURPOSE: Home
(home, irrigation, municipal, industrial)

WELL COMPLETION DATA:

- (1) diameter (inches) 2
- (2) total depth (feet) 304
- (3) static water level (feet) 8 below top of ground.
- (4) casing galv. 294' (material) (depth)
2" (size) if telescope see back.
- (5) screen 10' 294' (length) (depth to top)
2" stainless steel (size) (material)
- (6) pump Emerson (HP) (yield gpm)

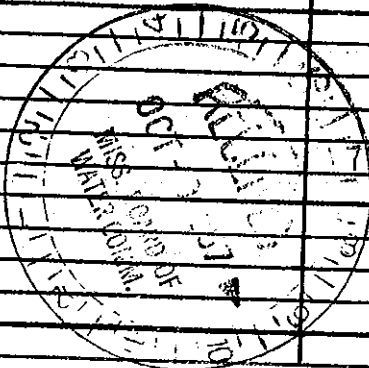

DRILLERS REMARKS: