

Hancock
 N 2065
 9-67

MISSISSIPPI
 BOARD OF WATER COMMISSIONERS
 416 North State Street
 Jackson, Mississippi 39201

WATER WELL DRILLERS LOG

9-28 1967 Sutter Well Works Hancock
 date well completed firm name county well located

LANDOWNER: ORON PATILLO
918 CONSTANTINOPLE
New Orleans La.
 (mailing address)


WELL LOCATION:
 sec. 6 T 9 N R. 14 E
4 miles W of Waukegan
 (distance) (direction) (nearest town)

WELL PURPOSE: home
 (home, irrigation, municipal, industrial)

WELL COMPLETION DATA:

- (1) diameter (inches) 2
- (2) total depth (feet) 154
- (3) static water level (feet) 6 below above top of ground.
- (4) casing galv., 149'
 (material) (depth)
2" If telescope see back.
 (size)
- (5) screen 5', 149'
 (length) (depth to top)
2", stainless steel
 (size) (material)
- (6) pump unknown
 (HP) (yield gpm)
 (type power)
- (7) electric log no
 (yes or no)
 (organization running log)
- (8) how well bottom plugged B.P. Value

description of formations encountered	from	to
Clay	0	10
sand	10	47
Clay	47	85
sand	85	120
Clay	120	143
sand	143	154

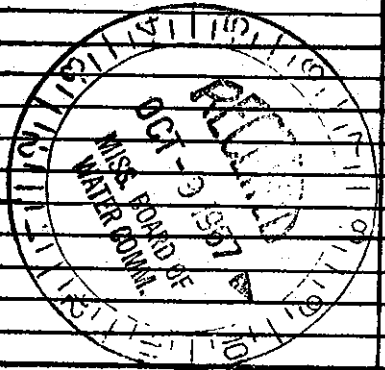

DRILLERS REMARKS: