

N2067

HANCOCK 67

N 20 70

3-68

MISSISSIPPI BOARD OF WATER COMMISSIONERS

416 North State Street  
Jackson, Mississippi 39201

WATER WELL DRILLERS LOG

3-11 1968  
date well completed

Sutton Well Works  
firm name

Hancock  
county well located

LANDOWNER: F. S. Reites

23 West Carroll

Bay St. Louis, Miss.  
(mailing address)

WELL LOCATION:

sec. 6 T 9 S R 14 W

4 miles West of Waveland  
(distance) (direction) (nearest town)

WELL PURPOSE: home  
(home, irrigation, municipal, industrial)


WELL COMPLETION DATA:

- (1) diameter (inches) 2
- (2) total depth (feet) 163
- (3) static water level (feet) 5 below above top of ground.
- (4) casing galv. 158' (material) (depth)  
2" if telescope see back. (size)
- (5) screen 5' 158' (length) (depth to top)  
2" stainless steel (size) (material)
- (6) pump unknown (HP) (yield gpm)  
elec (type power)
- (7) electric log no (yes or no)  
(organization running log)
- (8) how well bottom plugged BPU value

description of formations encountered

from to

Clay	0	14
sand	14	28
Clay	28	76
sand	76	98
Clay	98	147
sand	147	163

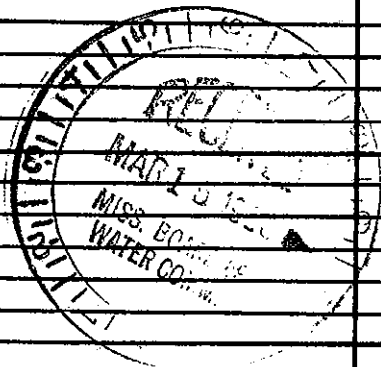

DRILLERS REMARKS: