

HAR
A 8
4-9-64

MISSISSIPPI BOARD OF WATER COMMISSIONERS

WATER WELL DRILLERS LOG *CODED*

Date: 4-9, 1964, Driller: Butler Well Works County Harrison
(Name)

(1) Owner of Land: International Paper
(Name)
Pass Christian, Miss.
(Address)

(2) Location: SW 1/4, SW 1/4, Sec. 9 T55R13
miles 1W, of Picville
(distance) (direction) (Nearest Town)

(3) Topography: hilly
(Hilly) (Flat) (Level)

(4) Purpose of Well: domestic
(Domestic Irrigation
Municipal, Industrial, Other)

Description & Color of Materials Sand, Clay, Red Clay, Shell, etc.	Thick- ness Feet	Depth Feet
<u>sand</u>	<u>18</u>	<u>18</u>
<u>clay</u>	<u>27</u>	<u>45</u>
<u>sand</u>	<u>45</u>	<u>90</u>
<u>clay</u>	<u>143</u>	<u>233</u>
<u>sand</u>	<u>30</u>	<u>263</u>
<i>CODED</i>		

Information upon completion of well:

(1) Diameter 2 inches.

(2) Total Depth 263 feet.

(3) Water Level 128 feet below top of ground.

(4) Cased to all, Size 2"


(5) Screen: Size 2", Length 10'

(6) Were any formations sealed against pollution?
no.

If YES depth of formation _____

Why _____

Drillers Remarks: _____

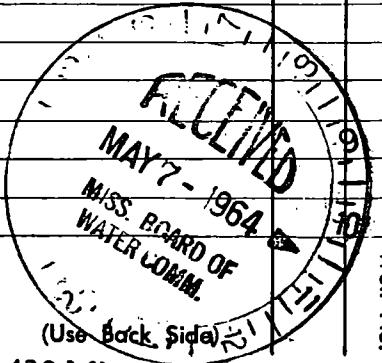

Well No.

