

HAR.

MISSISSIPPI BOARD OF WATER COMMISSIONERS

A 9
6-8-63

WATER WELL DRILLERS LOG

CODED

Date: June 8, 1963, Driller: H. A. Ladner County Harrison
(Name)

(1) Owner of Land:	Description & Color of Materials Sand, Clay, Red Clay, Shell, etc.	Thick- ness Feet	Depth Feet
<u>Ray Hewes Jr.</u> (Name) <u>Silver Run Lake</u> (Address)	<u>Red & Blue Clay</u>	<u>150</u>	
(2) Location: <u>1/4, 1/4, Sec. 4 T55R13W</u> <u>20</u> miles <u>West</u> , of <u>McDunkin</u> (distance) (direction) (Nearest Town)			
(3) Topography: <u>Hilly</u> (Hilly) (Flat) (Level)			
(4) Purpose of Well: <u>Domestic</u> (Domestic Irrigation Municipal, Industrial, Other)			

CODED


Information upon completion of well:

- (1) Diameter 2 inches.
- (2) Total Depth 170 feet.
- (3) Water Level 40 feet below top of ground.
- (4) Cased to 164, Size 2 inch
- (5) Screen: Size 2 inch Length 6
- (6) Were any formations sealed against pollution?
_____ yes, _____ no.

If YES depth of formation _____


Why _____

Drillers Remarks: _____

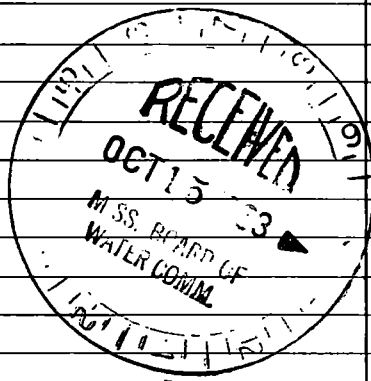

(Use Back Side)

Well No.

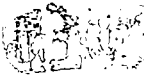

THE [illegible] [illegible]

23

[The remainder of the page contains extremely faint and illegible text, likely bleed-through from the reverse side of the document.]