

HAR.

A 12

CODED

WATER WELL DRILLERS LOG

11-10-64

Date: Nov 10, 1964, Driller: F Beer County Harrison

(Name)

(1) Owner of Land: Walter Lockwood
RT 2 Sulphur Springs
(Name) (Address) 55

(2) Location: DE 1/4, NW 1/4, Sec. 26 T. 10 R. 13
2 miles N of Lizana
(distance) (direction) (Nearest Town)

(3) Topography: X (Hill) (Flat) (Level)

(4) Purpose of Well: Home
(Domestic Irrigation, Municipal, Industrial, Other)

Description & Color of Materials Sand, Clay, Red Clay, Shell, etc.	Thick- ness Feet	Depth Feet
<u>Red Clay & sand</u>	<u>42</u>	<u>42</u>
<u>white sand</u>	<u>63</u>	<u>105</u>
<u>Hard Blue Clay</u>	<u>84</u>	<u>189</u>
<u>Fine sand</u>	<u>63</u>	<u>215</u>
<u>Soft Blue mud</u>	<u>79</u>	<u>294</u>
<u>Hard Blue mud</u>	<u>27</u>	<u>316</u>
<u>water sand</u>	<u>21</u>	<u>337</u>

CODED

Information upon completion of well:

(1) Diameter: 2" x 1 1/4" inches.

(2) Total Depth: 337 feet.

(3) Water Level: 49 feet below top of ground.

(4) Cased to _____, Size _____


(5) Screen: Size 1 1/4", Length 10 ft

(6) Were any formations sealed against pollution?
_____ yes, _____ no.

If YES depth of formation _____

Why _____

Drillers Remarks: _____

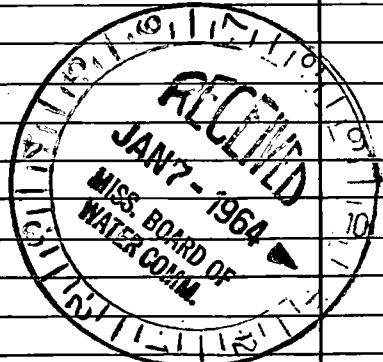

(Use Back Side)

Well No.

1000

20

