

Harrison
A 14
3-67

MISSISSIPPI
 BOARD OF WATER COMMISSIONERS
 416 North State Street
 Jackson, Mississippi 39201

CODED

WATER WELL DRILLERS LOG

March 24 1967 M&B Drilling Co. Harrison
 date well completed firm name county well located

LANDOWNER: Mr. Shows
San Juan, Miss.
 (mailing address)

description of formations encountered from to

Owner pulled old well.

We redrilled old hole & set plastic casing.

This well set in coarse white sand.


WELL LOCATION:
 sec 34 T 5 R 13
 S W
3 1/2 miles NW of Lizana
 (distance) (direction) (nearest town)

WELL PURPOSE: Home
 (home, irrigation, municipal, industrial)

WELL COMPLETION DATA:

- (1) diameter (inches) 2"
- (2) total depth (feet) 52
- (3) static water level (feet) 26 below top of ground. above
- (4) casing PPC Plastic, 46
 (material) (depth)
- If telescope see back.
 (size)
- (5) screen 6 FT, 46
 (length) (depth to top)
- 2", PPC Filter Pac Bonded
 (size) (material)
- (6) pump 1/2, 8
 (HP) (yield gpm)
- 110 V. 14
 (type power)
- (7) electric log No.
 (yes or no)
- (organization running log)
- (8) how well bottom plugged R" Cap

CODED

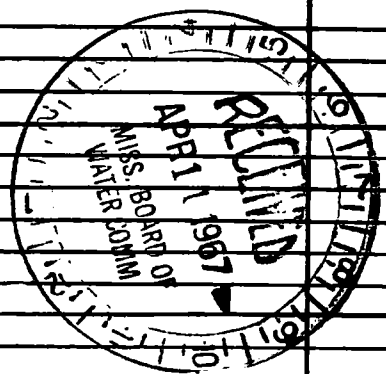

DRILLERS REMARKS:

If well telescopes please sketch and show depths.

GROUND LEVEL

			X

SECTION 24

Please indicate well location X.

ADDITIONAL INFORMATION

If more than one screen, show locations of each on sketch.