

1st report 2-19-69 by person
2nd report April 3/6/69

Harrison
A 16
12-1-67

MISSISSIPPI
BOARD OF WATER COMMISSIONERS
416 North State Street
Jackson, Mississippi 39201

WATER WELL DRILLERS LOG

CODED

Dec 1 19 67 date well completed
Labner's Well Works firm name
Harrison county well located

LANDOWNER: ~~Fred Labner~~
Labner
Sallier's mas.

description of formations encountered	from	to
yellow & Red clay	0	18
white sand	18	28
Blue clay	28	48
Blue sand	175	feet

(mailing address)

WELL LOCATION:
sec. 16 T 5 N R 13 E
S W
2 miles South E of ~~Labner~~
(distance) (direction) (nearest town)


WELL PURPOSE: Home
(home, irrigation, municipal, industrial)

WELL COMPLETION DATA:

- (1) diameter (inches) 2 inch
- (2) total depth (feet) 228 feet
- (3) static water level (feet) 19 ft ^(below) above top of ground.
- (4) casing 2 inch 205 feet
(material) (depth)
2 inch if telescope see back.
(size)
- (5) screen 5 feet 228 feet
(length) (depth to top)
008 Stainless steel
(size) (material)
- (6) pump 1/2 17
(HP) (yield gpm)
Flow
(type power)
- (7) electric log no
(yes or no)

(organization running log)
- (8) how well bottom plugged Back
Was the Valve


CODED

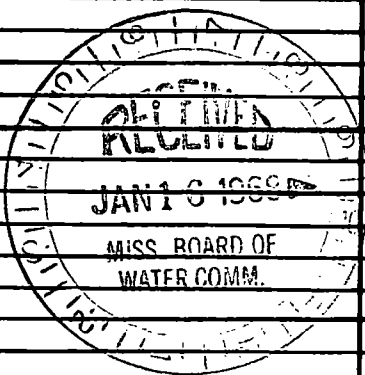

DRILLERS REMARKS:

If well telescopes please sketch and show depths.

GROUND LEVEL

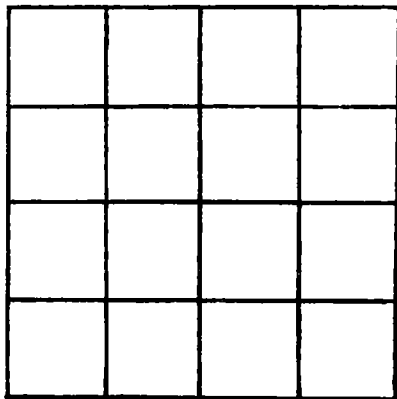

SECTION _____

Please indicate well location X.

ADDITIONAL INFORMATION

*Please send me one
of the new maps. It
will help alot*

If more than one screen,
show locations of each on sketch.